


LEGEND

- CONCRETE BOUNDPOST FOUND
- 3/4" Ø PIPE SET
- △ COMPUTED UNMARKED POINT
- ⊕ UTILITY POLE
- [68.56'] DATA IN BRACKETS PER FILED MAP
WHERE FOUND FIELD DATA DIFFERS

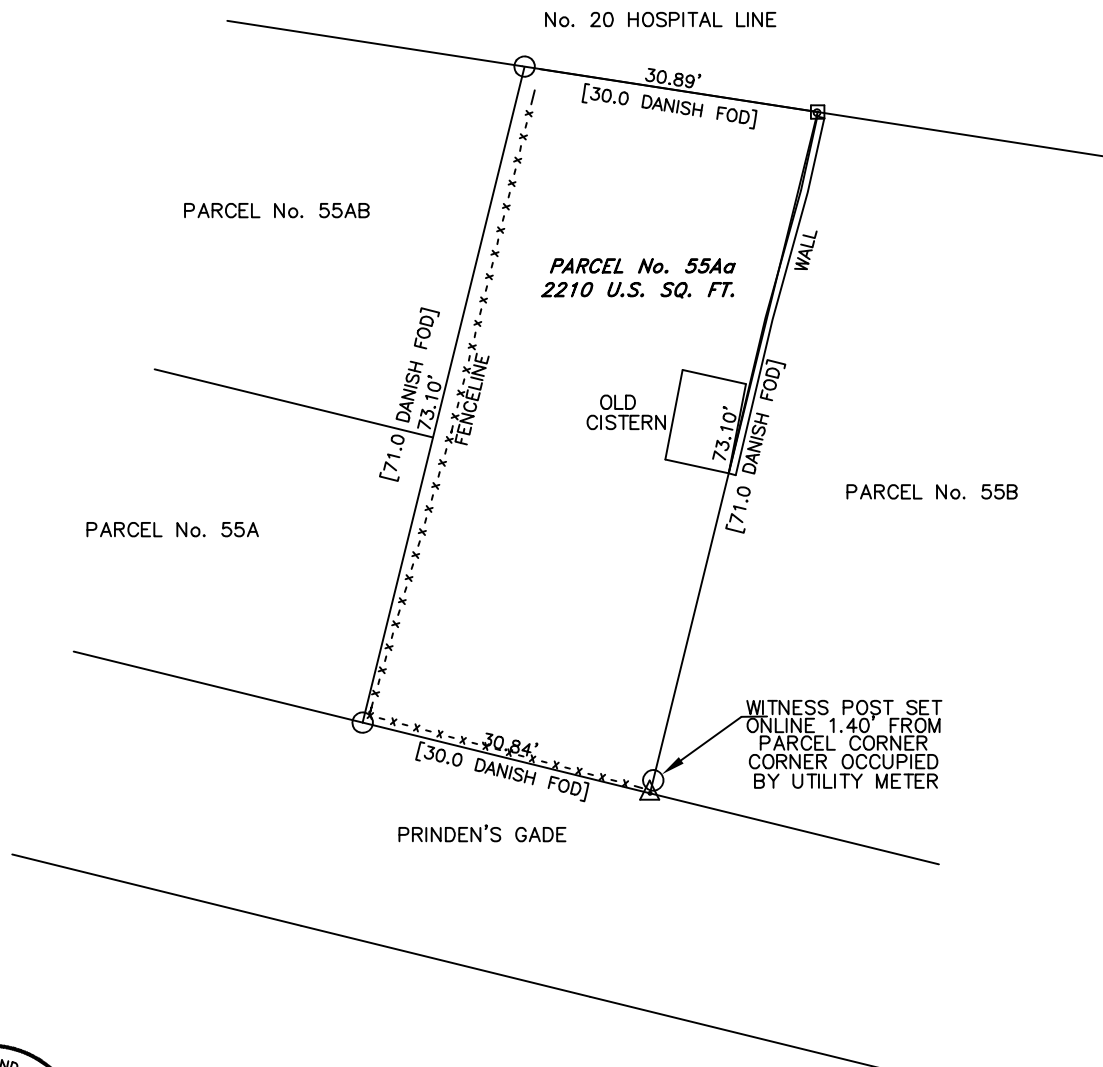

NOTES:
ZONE B-3
1 FOD = 1.0297 US FT

6501 RED HOOK PLAZA
SUITE 201, SAINT THOMAS, VI 00061-1308
340-775-8557 email: hga@marvinberning.com



MARVIN BERNING & ASSOCIATES

LAND SURVEYORS
SUBDIVISION PLANNING
PROPERTY SURVEYS

AS-BUILT SURVEY OF PARCEL No. 55Aa
PRINDSEN'S GADE
KINGS QUARTER
ST. THOMAS, U.S.V.I.

SURVEY: LOUIS
CALC.: GAURILLOFF
SCALE: 1" = 10'
DATE: 11/7/19
JOB NO. 4276

APPROVED BY:

Harry Gauriloff