


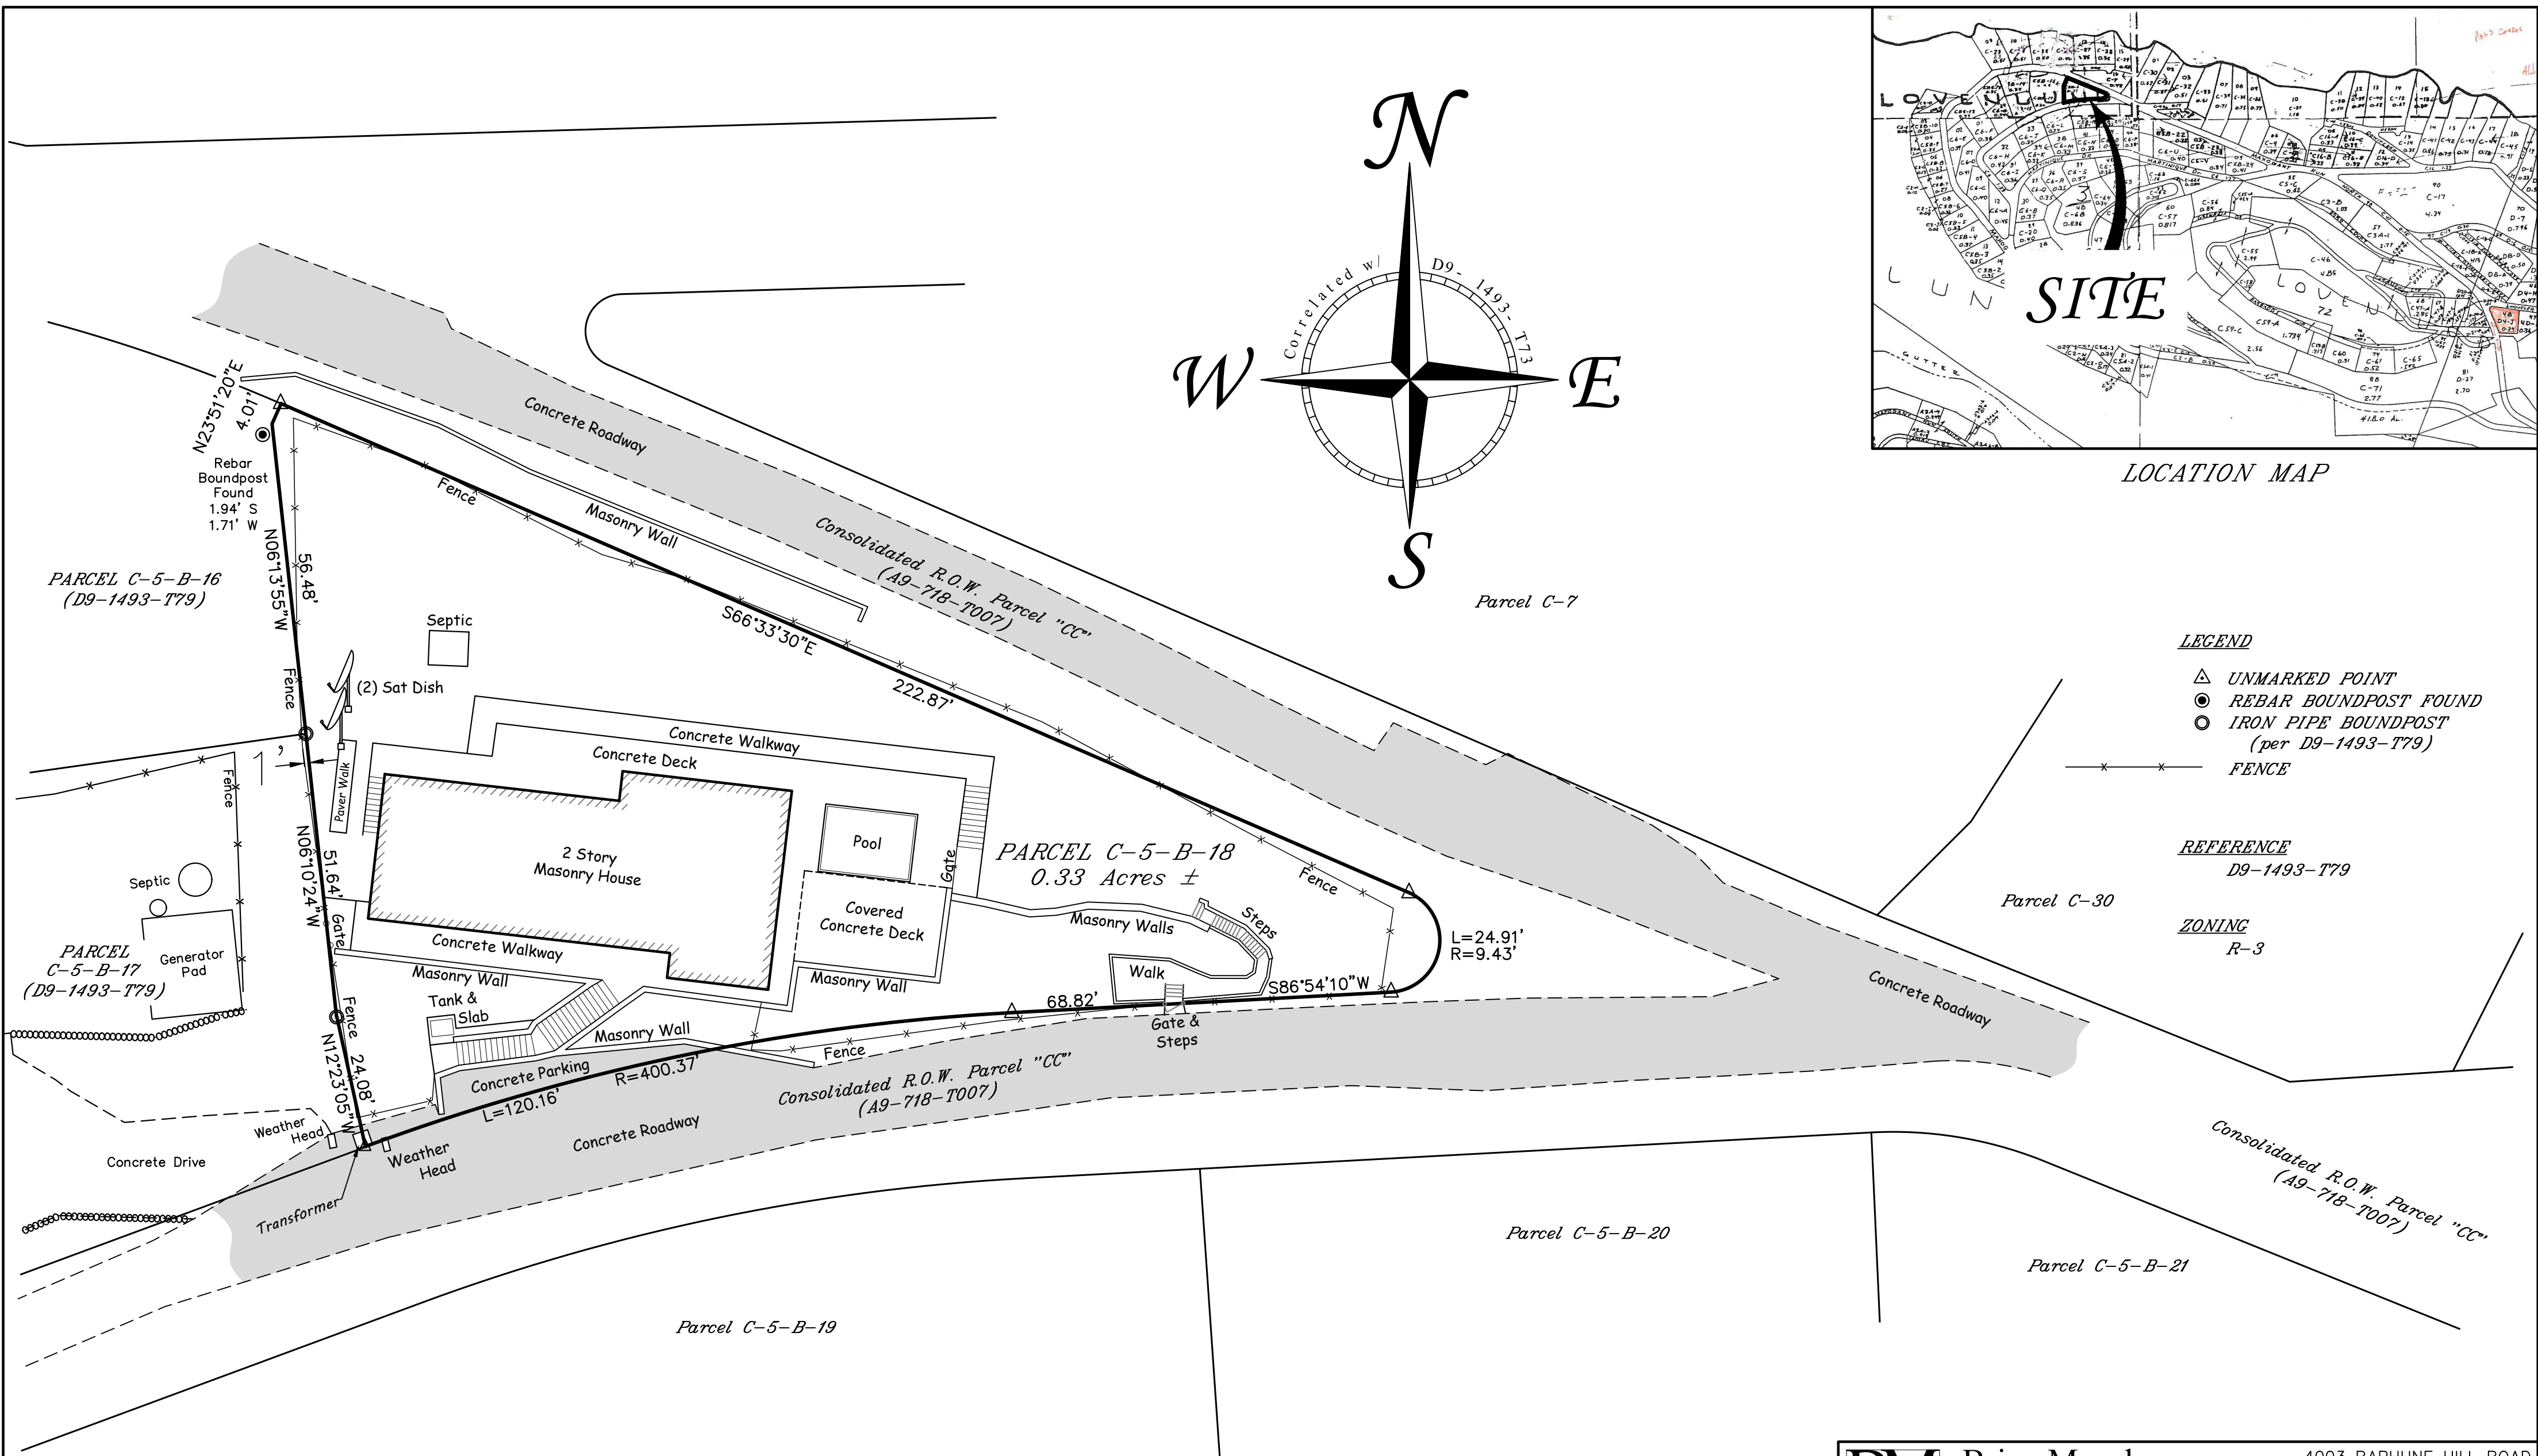


This is to certify that this map and the survey on which it is based were made in accordance with the 2016 Minimum Standard Detail Requirements for ALTA/NSPS Land Title Surveys, jointly established and adopted by ALTA and NSPS, and includes Items 4, 8, 11(a), 16, and 20 of Table A thereof. The field work was completed on 02 - 24 - 2021.

Date of Map: 02 - 25 - 2021.

BRIAN MOSELEY AND ASSOCIATES, INC.

Ryan C. Wischart
Ryan C. Wischart, PLS

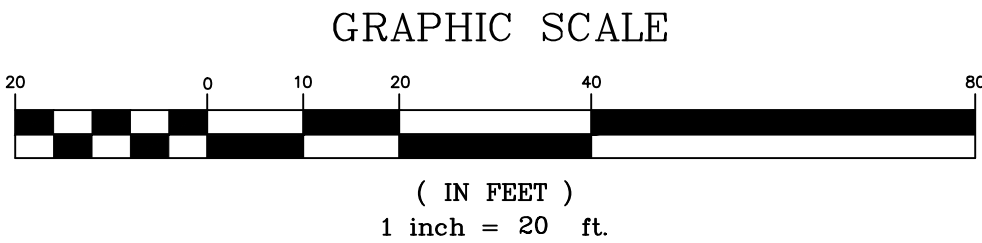

UPDATED SURVEY : 02-24-21
ORIGINAL SURVEY : 01-23-14



Brian Moseley
& Associates, Inc.
Land Surveyors & Consultants

4003 RAPHUNE HILL ROAD
SUITE 606
ST. THOMAS, VI 00802
PHONE (340) 774-5310
FAX (340) 776-4090

ALTA / NSPS Land Title Survey of
Parcel C-5-B-18
Estate Lovenlund
No. 2 Great Northside Quarter
St. Thomas, U.S. Virgin Islands

SURVEY: A. G. B.
CALC: R. C. W.

DRAWN: D. J. S.
SCALE: 1" = 20'

DATE:
02 - 25 - 2021

DWG No.:
6209 - 2