

MAFOLIE ROAD

ASPHALT PAVEMENT

HOSPITAL LINE

UTILITY BOXES

RUINS OF OLD
STONE WALLS

OLD STEPS

RUINS OF OLD STONE BUILDING

PARCEL No. 20
4513 SQ. FT.
[4500 SQ. DANISH FODS]

CONCRETE SIDEWALK

53.56' [52 DANISH FOD]
RUINS OF OLD STONE WALL

DIRT PARKING AREA

KANAL GADE
(GHUT)

47.38' [46' DANISH FOD]

90.64' [88' DANISH FOD]

FENCELINE

WALL


MASONRY BUILDING

PARCEL No. 55AB
PRINDSEN'S GADE

PARCEL No. 55Aa
PRINDSEN'S GADE

PARCEL No. 55B
PRINDSEN'S GADE

MEASURE BRIEF 8/28/1844

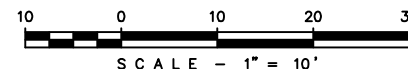

LEGEND

- 1/2" Ø REBAR SET
- 3/4" Ø PIPE SET
- ☆ SURVEY NAIL SET IN TREE
- UTILITY POLE
- [68'] DATA IN BRACKETS PER FILED MAP
IN DANISH FODS

NOTES:
ZONE B-3
1 FOD = 1.0297 US FT

6501 RED HOOK PLAZA
SUITE 201, SAINT THOMAS, VI 00802-1306
340-775-8557
email: hylmar@hylmar.com



MARVIN BERNING & ASSOCIATES

LAND SURVEYORS
SUBDIVISION PLANNING
PROPERTY SURVEYS

AS-BUILT SURVEY OF PARCEL No. 20
HOSPITAL LINE
KINGS QUARTER
ST. THOMAS, U.S.V.I.

SURVEY: LOUIS
CALC.: GAURILLOFF
SCALE: 1" = 10'
DATE: 4/30/21
JOB NO. 4479

APPROVED BY:

Harry Gauriloff