


THIS CERTIFICATION IS MADE ONLY TO HEREIN NAMED PARTIES OF HEREIN DELINEATED PROPERTY. NO RESPONSIBILITY OR LIABILITY IS ASSUMED BY SURVEYOR FOR USE OF SURVEY FOR ANY OTHER PURPOSE INCLUDING, BUT NOT LIMITED TO, USE OF SURVEY FOR SURVEY APPRAISAL, RESALE OF PROPERTY, OR TO ANY OTHER PERSON NOT LISTED IN CERTIFICATION, EITHER DIRECTLY OR INDIRECTLY.

SUBJECT TO EASEMENTS AND RESTRICTIONS THAT AFFECT SUBJECT PROPERTY. SUBJECT TO AN ACCURATE TITLE SEARCH. UNDERGROUND UTILITIES-UNDERGROUND TANKS-TREES-LANDSCAPE FEATURES-HAZARDOUS WASTE-FRESHWATER WETLANDS-FLOOD-RIPARIAN DELINEATIONS, IF ANY, ARE NOT SHOWN HEREIN.

A WRITTEN WAIVER AND DIRECTION NOT TO SET CORNER MARKERS HAS BEEN OBTAINED FROM THE ULTIMATE USER PURSUANT TO P.L.2003, c.14(C45) 8-36.3) AND N.J.A.C. 17:46-5.1 (d).

LEGEND:

209.20
+ = EXISTING ELEVATION
ELEVATIONS BASED ON
NAVD' 88 DATUM

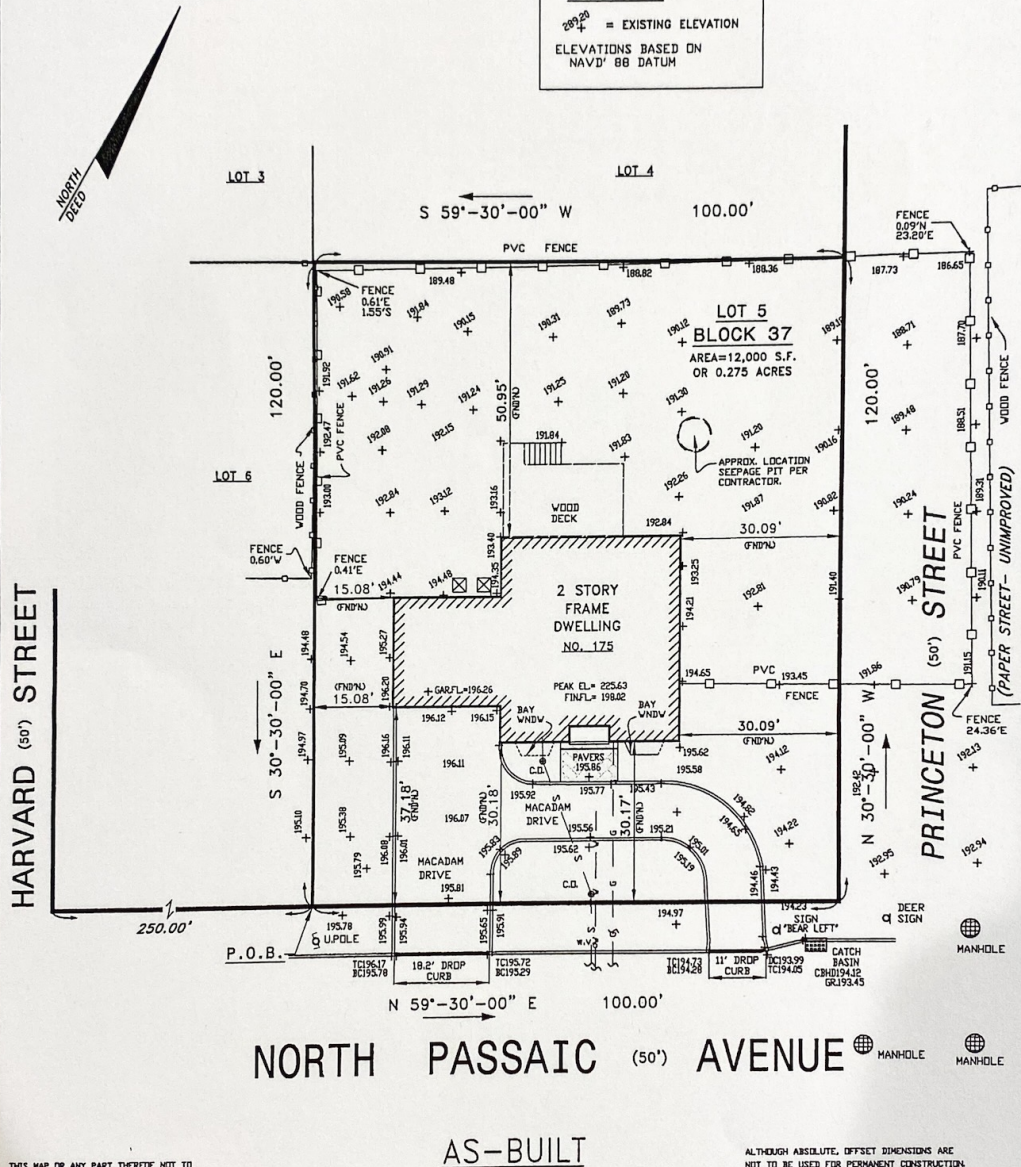

THIS MAP OR ANY PART THEREOF NOT TO BE REPRODUCED WITHOUT WRITTEN CONSENT OF GB ENGINEERING, LLC AND/OR DVM ©COPYRIGHT.


CERTIFIED TO: CHRYSTIAN RODAK

MAP: BOROUGH OF CHATHAM TAX MAP AND A MAP ENTITLED: "CHATHAM REALTY AND DEVELOPMENT CO", FILED IN THE M.C.C.D. ON FEB. 5, 1924 AS MAP NO. 627-C.

DEED BOOK 5201, PAGE 351.

THOMAS G. STEARNS III - LIC. NO. GB40959
N.J. PROFESSIONAL ENGINEER & LAND SURVEYOR

GRAPHIC SCALE: 1"=20'

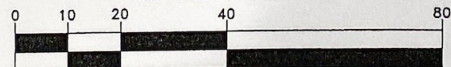

AS-BUILT FOR
CHRYSTIAN RODAK

LOT: 5 T.M. 37 T.M.
192 & 193 F.M. BLOCK: - F.M.

BOROUGH OF CHATHAM
MORRIS COUNTY, NEW JERSEY

GB ENGINEERING, LLC
ENGINEERS AND SURVEYORS
144 JEWELL STREET GARFIELD, NEW JERSEY 07026
EMAIL: GBSURVEYOR@AOL.COM
TEL (973) 340-0948 FAX (973) 340-0015

SCALE: 1"=20'
DATE: JULY 22, 2021
CERTIFICATE OF AUTHORIZATION NO: 24GA-28110300

VDS

TITLE NO. -

REVISED:

Work Order: 2021/0770